

South Carolina Department of Health and Environmental Control
Office of Ocean and Coastal Resource Management
1362 McMillan Avenue, Suite 400
Charleston, South Carolina 29405

February 25, 2014
Permit Amendment Public Notice

Timothy Assey, OCRM-04-120-R

The Department has received an application for a permit for the alteration of a critical area. The application was submitted pursuant to the Coastal Zone Management Act (Act 123) of 1977 South Carolina General Assembly. The application in brief, is described as follows:



LOCATION: On and adjacent to Beresford Creek at 1523 Creekside Way, Charleston, Berkeley County, South Carolina.
TMS: 271-00-03-088.

WORK: The permittee for the issued permit is seeking an after-the-fact amendment. Specifically, the permittee seeks to keep the installed 7' x 12' floating boatlift that is landward of the existing 12' x 20' floating dock. The amendment is for AFTER-THE-FACT approval for modifications at a private, recreational dock.

This public notice is being distributed to all known interested persons and agencies to assist in developing facts on which a decision by the Department can be based. Comments concerning the proposed work must be submitted in writing, setting forth sufficient detail to furnish a clear understanding of the reasons for support or opposition.

Comments regarding this application must be received by the Department on or before **March 7, 2014**. For more information, please contact:
Jeff Thompson at 843-953-0219 or via email at thompsdj@dhec.sc.gov.

NOTE: Plans depicting the proposed work are available and will be provided upon receipt of a written request or may be viewed on the Department website at **www.scdhec.gov/environment/ocrm/public_notice.htm**.

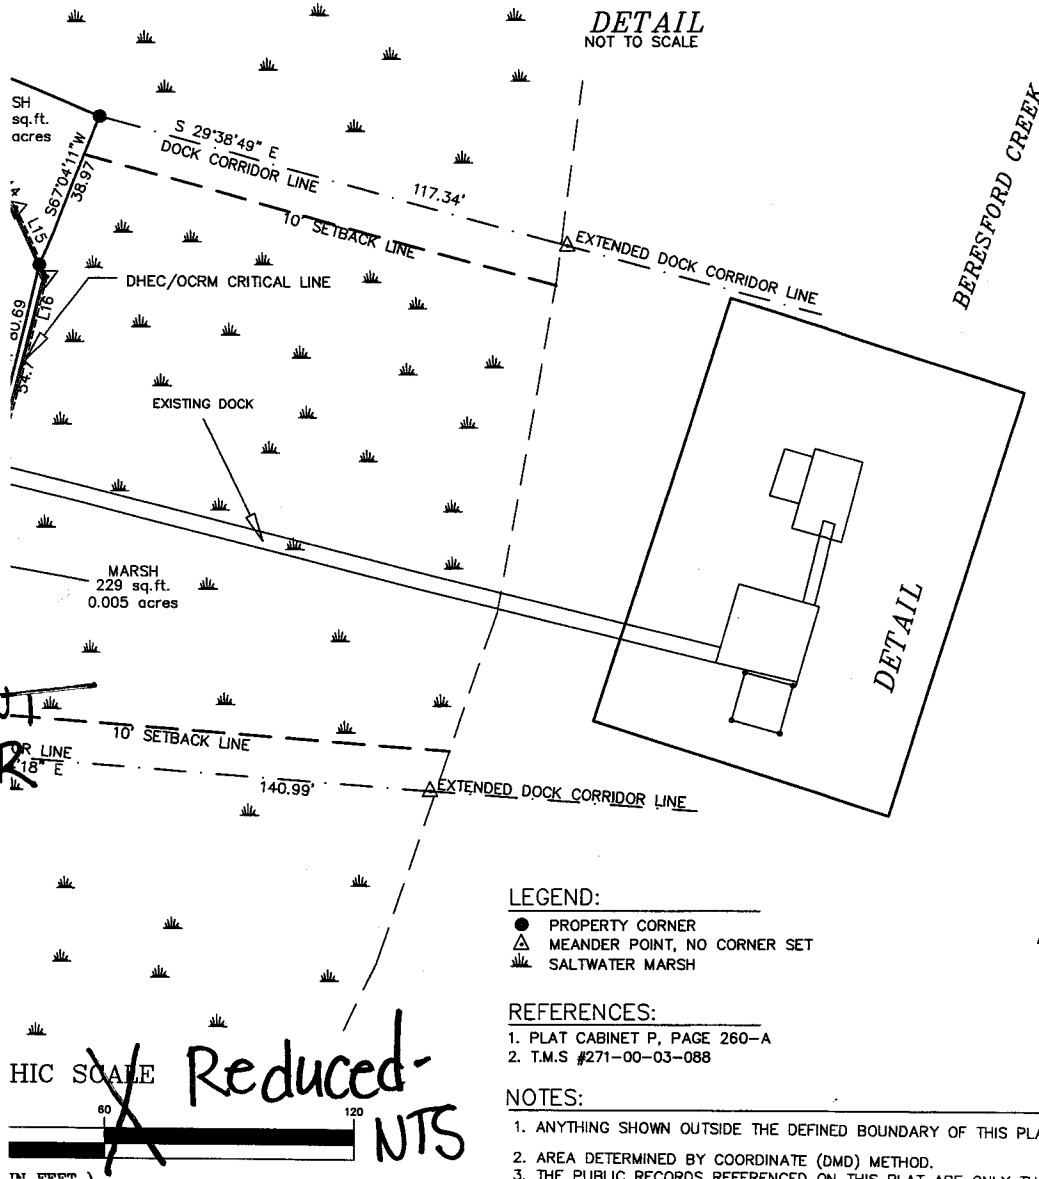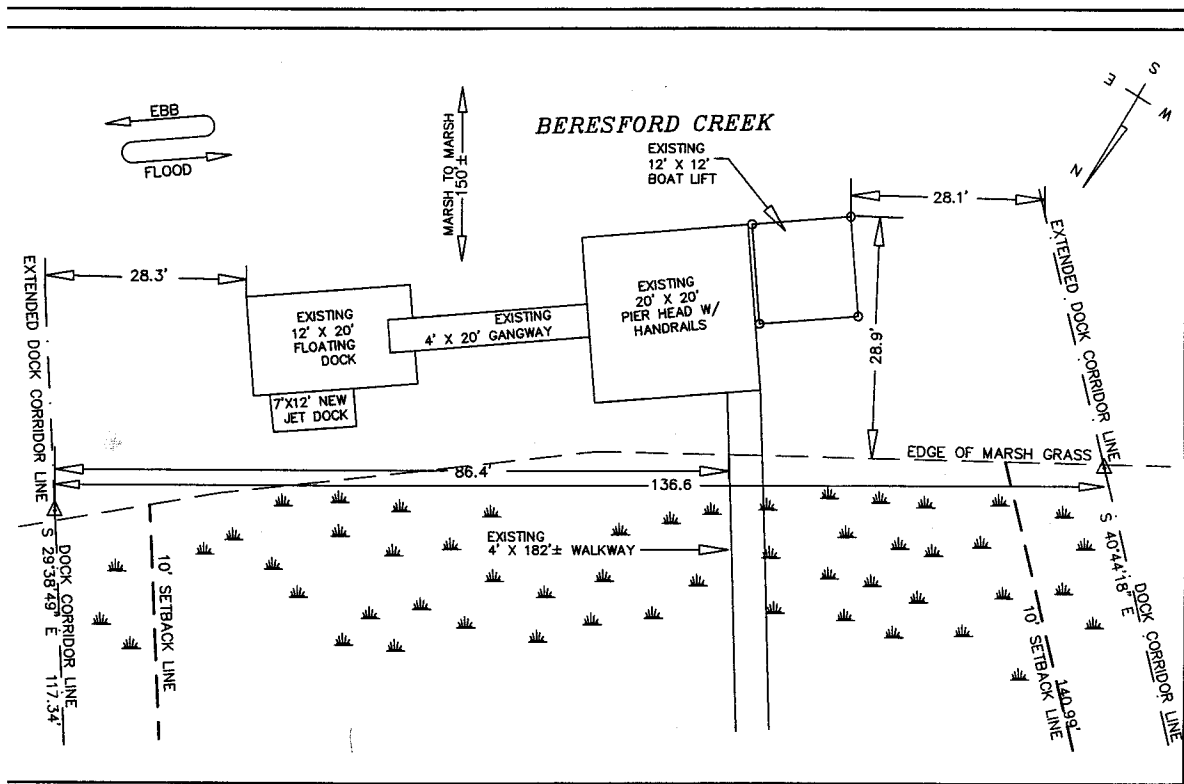

LEGEND:

- PROPERTY CORNER
- △ MEANDER POINT, NO CORNER SET
- ▒ SALTWATER MARSH

REFERENCES:

1. PLAT CABINET P, PAGE 260-A
2. T.M.S #271-00-03-088

NOTES:

1. ANYTHING SHOWN OUTSIDE THE DEFINED BOUNDARY OF THIS PLAT
2. AREA DETERMINED BY COORDINATE (DMD) METHOD.
3. THE PUBLIC RECORDS REFERENCED ON THIS PLAT ARE ONLY THOSE USED

HIC SCALE

Reduced-
NTS

1035-B Jenkins Road
Charleston, SC 29407
(843) 795-9330

CRITICAL LINE AND DOCK ASBUILT
LOT 107 CREEK SIDE WAY
BERESFORD CREEK SUBDIVISION

DATE: 12-17
DRAWN: M.J.S
CHECK: J.T.B
CC: L.C.

ATF
AMENDMENT
OCRM-04-120-R
Assey